




# INDIAN RIVER COUNTY/CITY OF VERO BEACH BUILDING DIVISION

1801 27<sup>th</sup> Street, Vero Beach, FL 32960 772- 226-1260

## Fence Permit Checklist

*The following items are required with submission of your permit application:*

- A completed Indian River County/City of Vero Beach Scope of Work permit application.
- Owner/Builder Disclosure Statement when applicable.
- Documentation that verifies job value. Examples include a copy of the signed contract between the owner and contractor or a signed estimate, etc.
- 2 copies of a legible survey or site plan indicating fence location and any gates. Please indicate type of fence, height of fence, proposed length of each section of fencing along with location, number and size of gates. If fence is to be a Pool Barrier please indicate in writing on the survey and on the application.
- Residential and Commercial fence permits require approval from the Planning Department having jurisdiction. Commercial Fence permits also require a Fire Prevention Bureau review and will need to be submitted for review.
- A Recorded Notice of Commencement (NOC) preferred to be submitted with application but must be submitted prior to first inspection if job value exceeds \$2500.
- Applicants are advised that Building Permit Applications are considered incomplete until all other IRC/COVB Departments and other Governmental agency reviews are completed and approved. The Building Permit Application will be routed to other departments, even if considered incomplete, in order to expedite the review process. The Building Permit Application review and approval time clock does not start until the application is deemed a Complete Application.

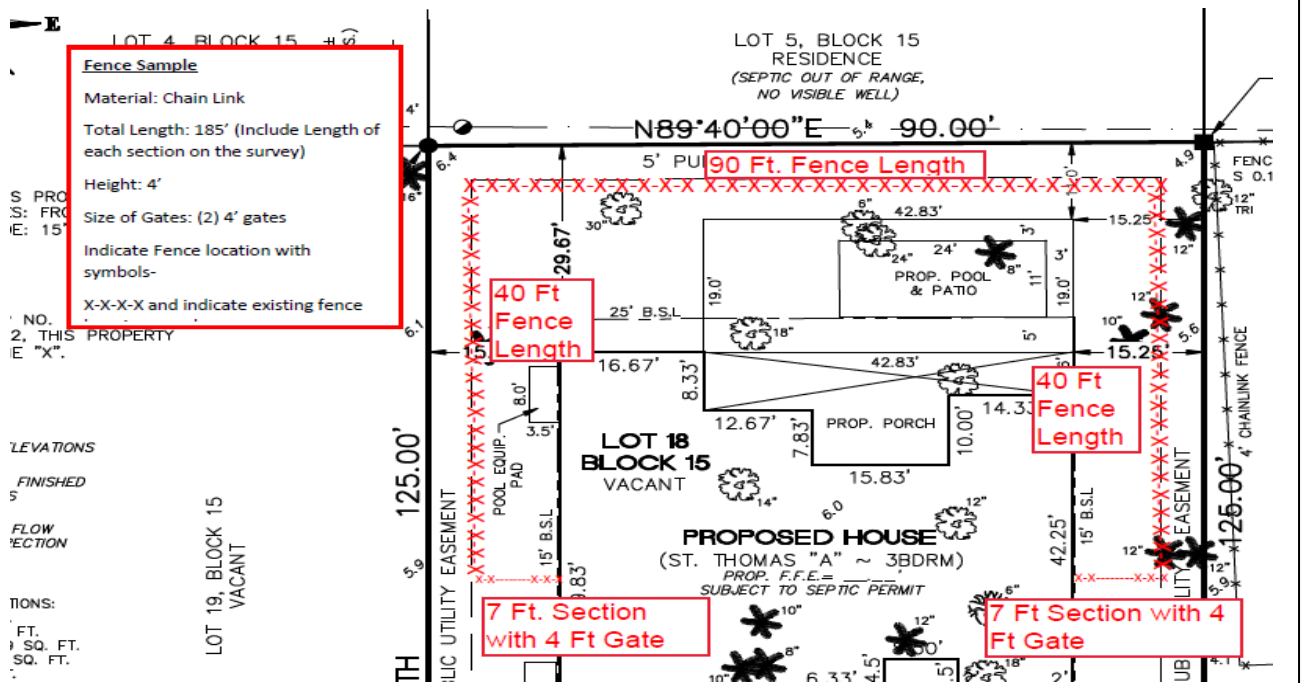

Additional documents may be requested at any time during the permitting process. For permitting and submittal questions please contact the Building Division at 772-226-1260.



INDIAN RIVER COUNTY/CITY OF VERO BEACH
BUILDING DIVISION

1801 27th Street, Vero Beach, FL 32960 772- 226-1260

SCOPE OF WORK APPLICATION
BUILDING DIVISION

PARCEL NUMBER: (from tax notice \ receipt)

OWNER'S NAME: JOB ADDRESS:

COMPANY NAME: QUALIFIER NAME:

LICENSE #: COUNTY COMP CARD #:

PHONE #: FAX #: E-MAIL:

JOB VALUE: \$ RESIDENTIAL COMMERCIAL
SEPTIC SYSTEM SEWER CONNECTION

- Alarm - Low Voltage or Wireless Aluminum Construction Trailer Demolition (Interior Only)
Dock/Seawall Driveways/ Slabs Electrical Fence Garage Doors Irrigation
Insulation Mechanical Plumbing Pool Re-Surface Shed Tie-Down Solar
Other

\*Fence permits: APPLICANT INDICATES: Fence will be a Pool Barrier\*\* Year pool was built:
\*\*NOTE: Fence must comply with Current FBC Pool Barrier Code unless other approved barrier is provided.

Scope of the work anticipated in this permit application.

Blank lines for describing the scope of work.

NOTICE OF COMMENCEMENT IS REQUIRED IF JOB VALUE EXCEEDS \$2,500 (Air Conditioning - \$7,500)

Applicant's Affirmation

Application is hereby made to obtain a permit to do the work and installations as indicated. I certify that no work or installation has commenced prior to the issuance of a permit, and that all work will be performed to meet the standards of all laws regulating construction, insurance, and worker's compensation. I understand that a separate permit must be secured for ELECTRICAL WORK, PLUMBING, SIGNS, WELLS, POOLS, FURNACES, BOILERS, HEATERS, TANKS AND AIR CONDITIONER, ETC. Properties on which earth spills or other debris falls shall be cleaned immediately. All streets, sidewalks, and curbs damaged due to this construction shall be repaired to the satisfaction of the Engineering Department prior to the issuance of Certificate of Completion. IN APPLYING FOR THIS PERMIT, I HEREBY ATTEST THAT I HAVE THE KNOWLEDGE AND UNDERSTANDING OF ALL THAT IS REQUIRED BY THE FLORIDA BUILDING CODE AND ALL LAWS AND REGULATIONS PERTAINING TO PERFORMING AND COMPLETING THIS TYPE OF WORK.



INDIAN RIVER COUNTY/CITY OF VERO BEACH
BUILDING DIVISION

1801 27th Street, Vero Beach, FL 32960 772- 226-1260

OWNER'S AFFIDAVIT: I certify that all the foregoing information is accurate and that all work will be done in compliance with all applicable laws regulating construction and zoning.

WARNING TO OWNER: YOUR FAILURE TO RECORD A NOTICE OF COMMENCEMENT MAY RESULT IN YOUR PAYING TWICE FOR IMPROVEMENTS TO YOUR PROPERTY. A NOTICE OF COMMENCEMENT MUST BE RECORDED AND POSTED ON THE JOB SITE BEFORE THE FIRST INSPECTION. IF YOU INTEND TO OBTAIN FINANCING, CONSULT WITH YOUR LENDER OR AN ATTORNEY BEFORE COMMENCING WORK OR RECORDING YOUR NOTICE OF COMMENCEMENT.

Owner Signature

Contractor Signature

Acknowledgement for Person in an Individual Capacity

State of Florida, County of The foregoing instrument was acknowledged before me by means of physical presence or online notarization this day of 20 by

who is personally known or produced identification Type of ID Produced Printed Name of Notary Signature of Notary Notary Seal

State of Florida, County of The foregoing instrument was acknowledged before me by means of physical presence or online notarization this day of 20 by

who is personally known or produced identification Type of ID Produced Printed Name of Notary Signature of Notary Notary Seal

Acknowledgement for Person in a Representative Capacity

State of Florida, County of The foregoing instrument was acknowledged before me by means of physical presence or online notarization this day of 20 by (Name of Person) as ( Explain

Representative Capacity) for (Name of Party on Behalf of Whom Instrument was Executed).

who is personally known or produced identification Type of ID Produced Printed Name of Notary Signature of Notary Notary Seal

State of Florida, County of The foregoing instrument was acknowledged before me by means of physical presence or online notarization this day of 20 by (Name of Person) as ( Explain

Representative Capacity) for (Name of Party on Behalf of Whom Instrument was Executed).

who is personally known or produced identification Type of ID Produced Printed Name of Notary Signature of Notary Notary Seal